
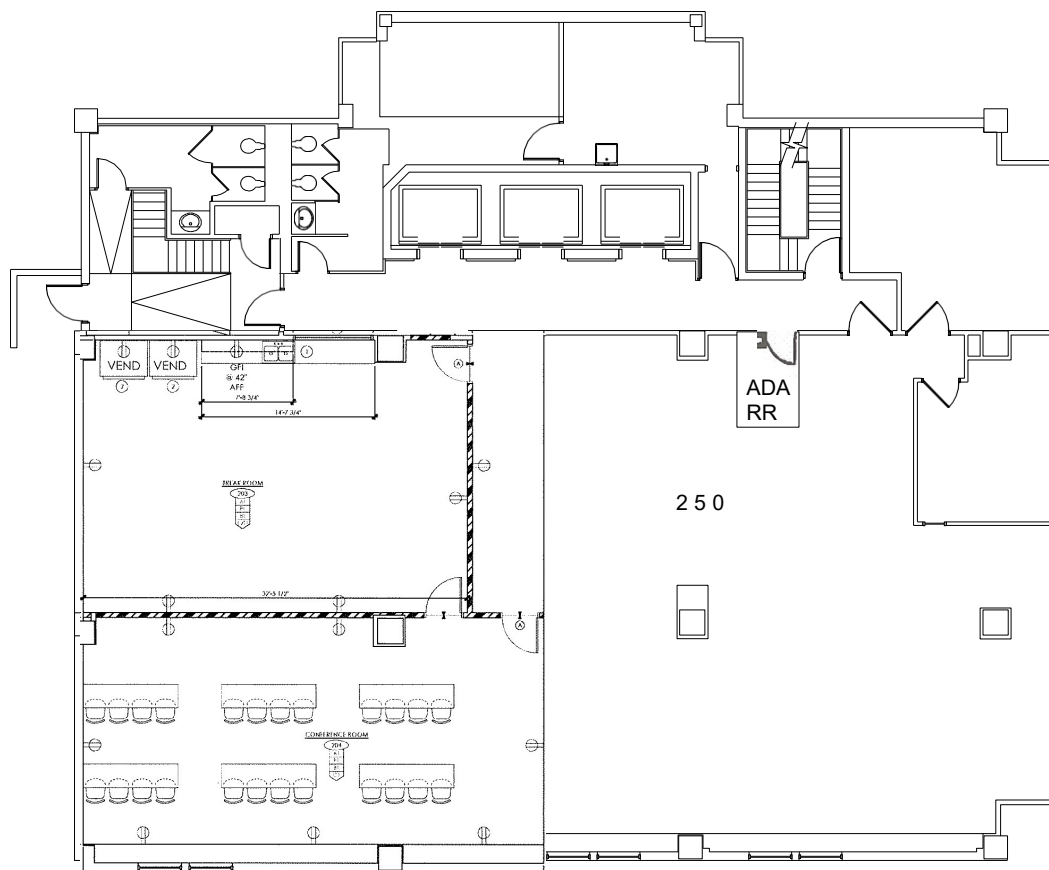


SUITE 200
 Conference Room / Break Room
 1995.08 RSF

SUITE 250
 AVAILABLE
 2549.24 RSF

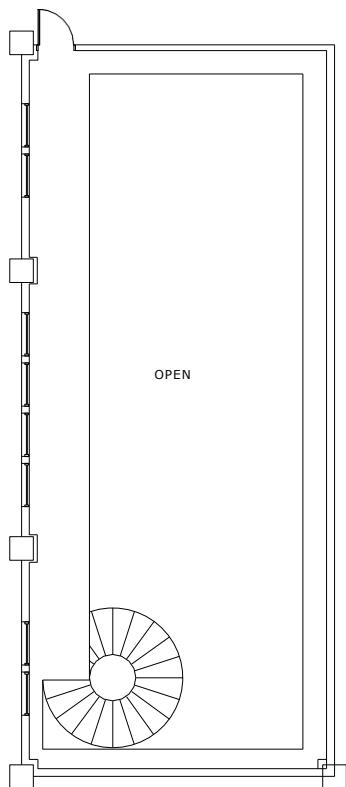

**2ND FLOOR
 PLAN**

SOUTHLAND
 TOWER
 2ND FLOOR



10.25.2019



A FLOOR PLAN

SCALE: N.T.S.



NORTH

AS-BUILT
 PLAN

AS.2