


SUITE 1100  
 MIDAMERICA  
 1599 RSF

SUITE 1170  
 VACANT  
 1458 RSF

SUITE 1180 / 1190  
 AVEANNA  
 5,283 RSF

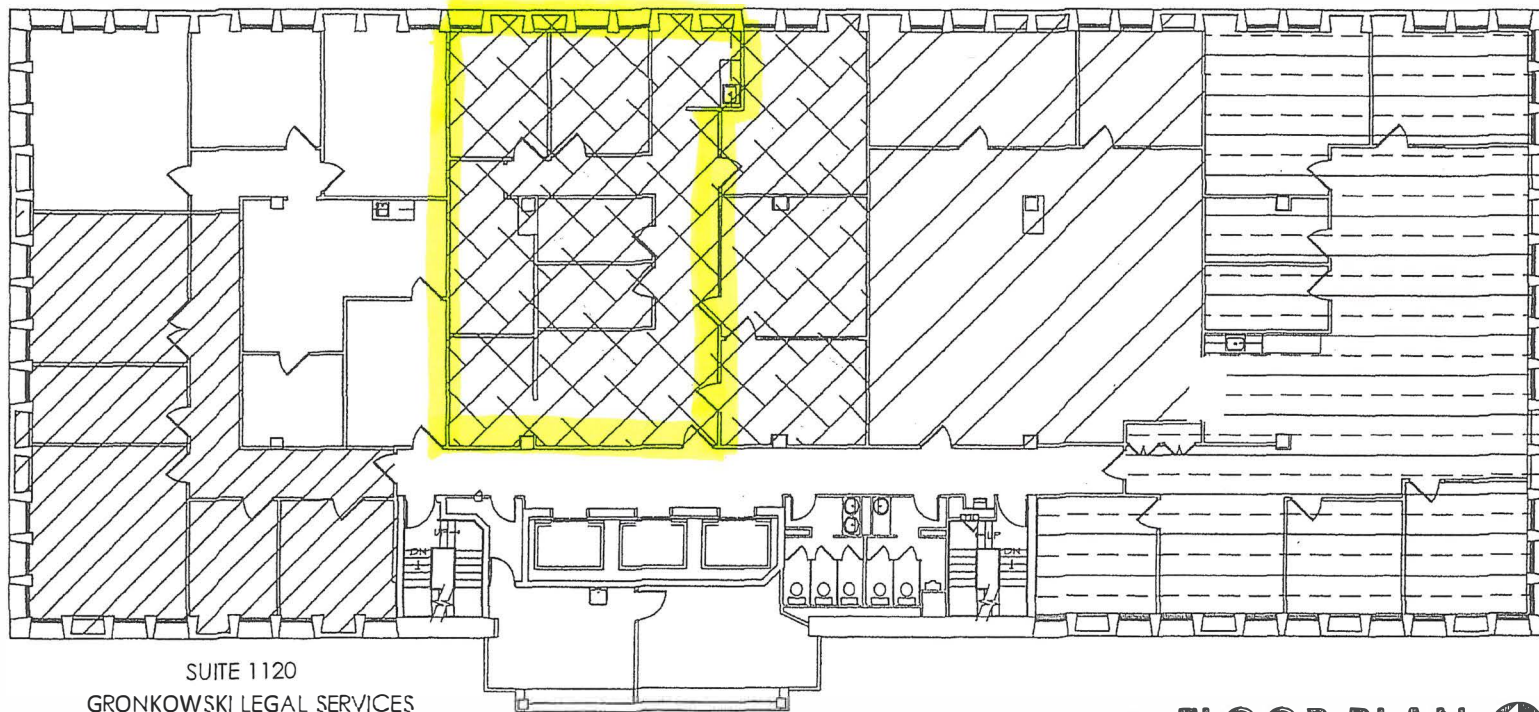

SUITE 1120  
 GRONKOWSKI LEGAL SERVICES  
 1441 RSF

**A FLOOR PLAN**   
 SCALE: N.T.S. NORTH

**11TH  
 FLOOR**

SOUTHLAND  
 TOWER  
 11TH FLOOR

PRICE  
 EDWARDS  
 AND COMPANY

03.05.2021

AS-BUILT  
 PLAN  
**AS.11**