


SUITE 1200
AVAILABLE
3,788.85 USF
4,357.18 RSF

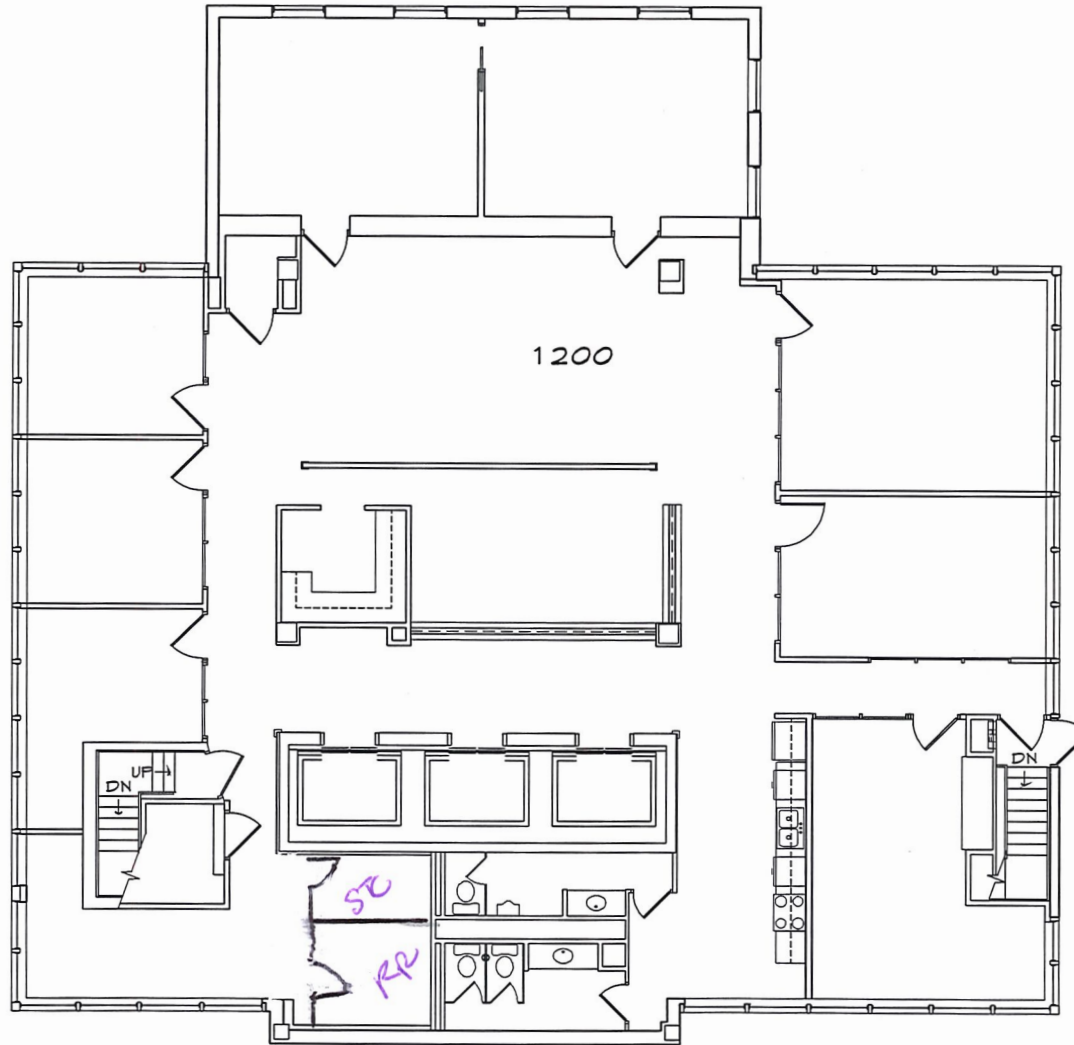

A FLOOR PLAN

SCALE: N.T.S.



NORTH



KKT ARCHITECTS, INC.
2200 SOUTH UTICA PLACE, SUITE 200
TULSA, OKLAHOMA 74114
[P] 918.744.4270 \ [F] 918.744.7849
WWW.KKTARCHITECTS.COM
C OF A #534 6/30/23

12TH FLOOR PLAN

SOUTHLAND
TOWER

PRICE
EDWARDS
AND COMPANY

2022.11.10

AS-BUILT
FLOOR PLAN

AS12