


SUITE 300  
 AVAILABLE  
 10,256.63 RSF

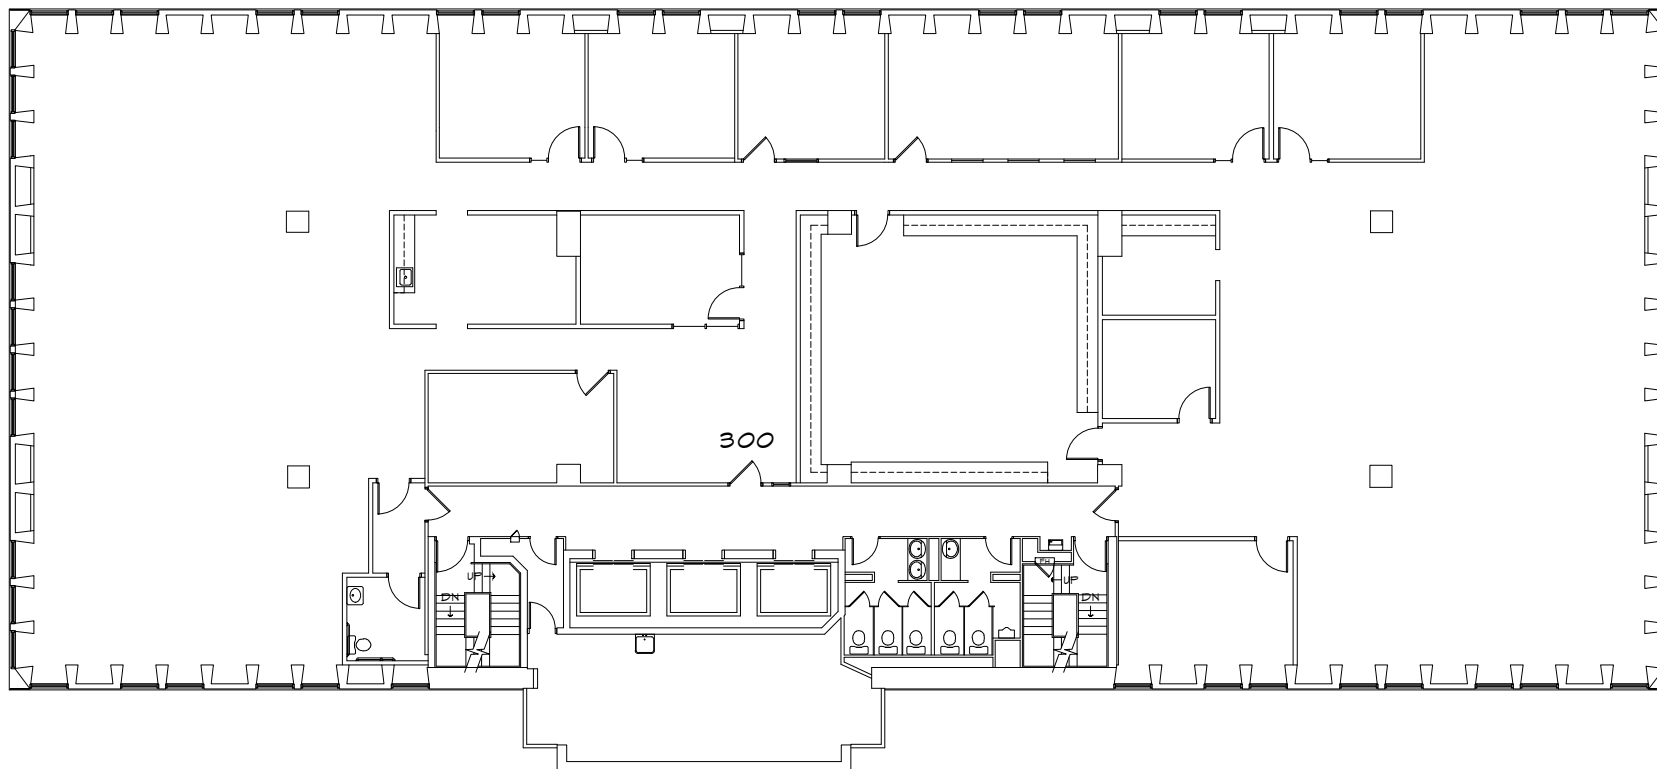

**3RD FLOOR  
 PLAN**

SOUTHLAND  
 TOWER  
 3RD FLOOR



10.25.2019



**A FLOOR PLAN**   
 SCALE: N.T.S. NORTH

AS-BUILT  
 PLAN

**AS.3**