

**6TH FLOOR  
 PLAN**

SOUTHLAND  
 TOWER  
 6TH FLOOR



10.25.2019  
 .  
 .  
AS-BUILT  
 PLAN


**AS.6**

SUITE 600  
 AVAILABLE  
 3075.10 RSF

SUITE 605  
 UNITY COUNSELING  
 1434.05 RSF

SUITE 610  
 AVAILABLE  
 1141.92 RSF

SUITE 650  
 NEW CENTURY HOSPICE  
 3166.76 RSF

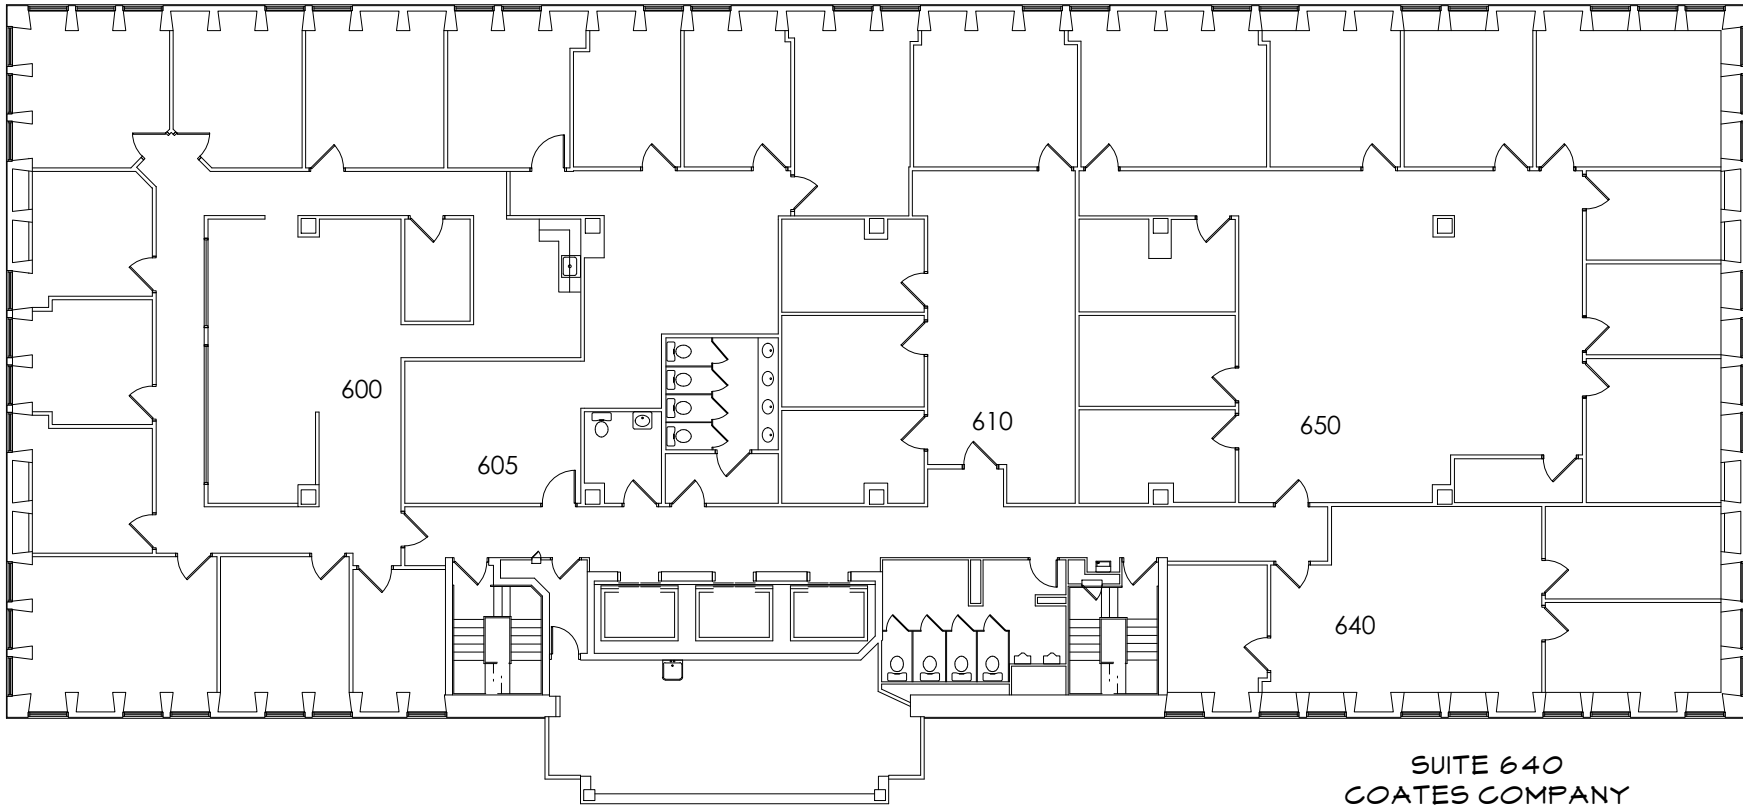

SUITE 640  
 COATES COMPANY  
 1061.91 RSF

**A FLOOR PLAN**   
 SCALE: NTS NORTH