


SUITE 700  
AVAILABLE  
10,271.95 RSF

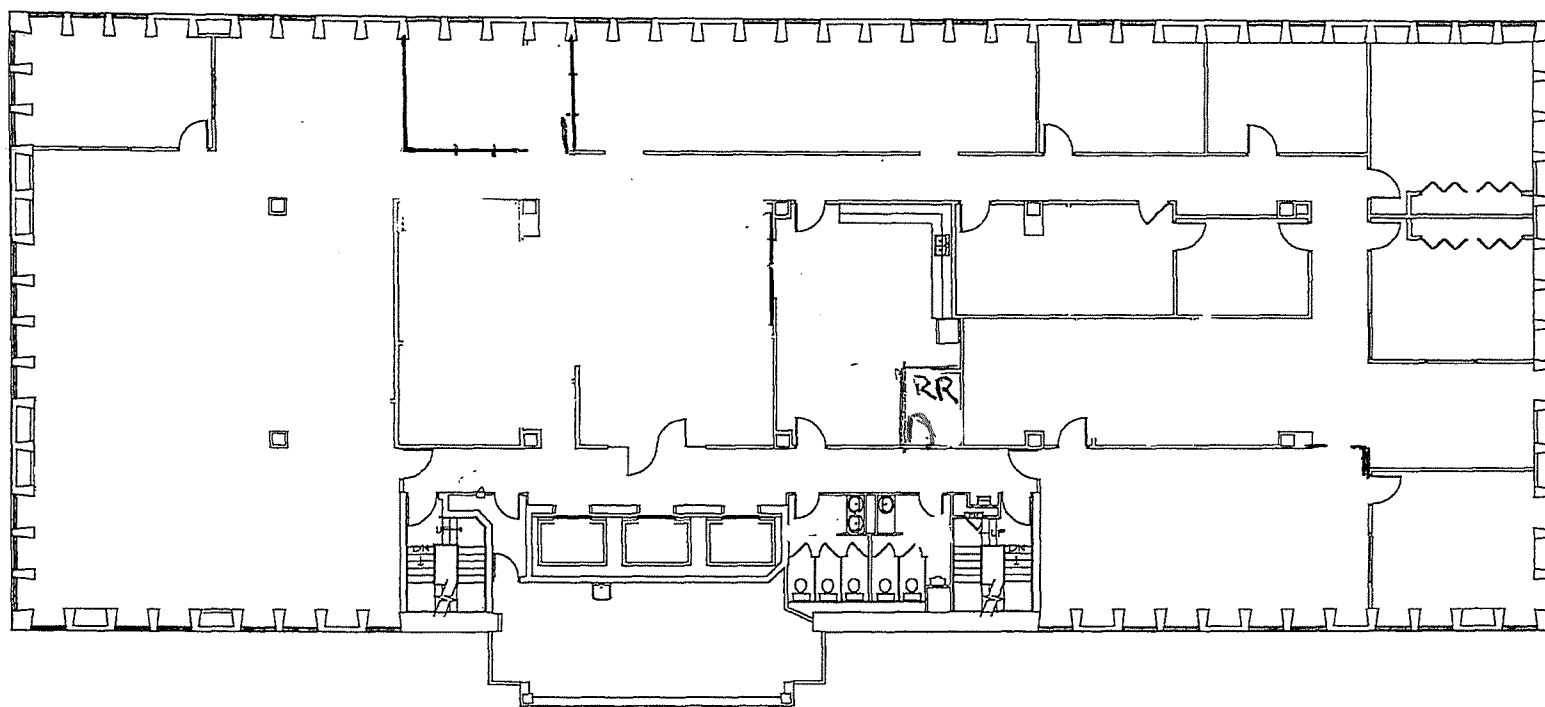

**A FLOOR PLAN**   
SCALE: N.T.S. NORTH



KKT ARCHITECTS, INC.  
2200 SOUTH UNCA PLACE, SUITE 200  
TULSA, OKLAHOMA 74114  
[P] 918.744.4270 \ [F] 918.744.7849  
WWW.KKTARCHITECTS.COM  
C OF A #534 6/30/19

## 7TH FLOOR PLAN

SOUTHLAND  
TOWER  
7TH FLOOR



10.25.2019

AS-BUILT  
PLAN

# AS.7