


# fKKT

ARCHITECTURE \ INTERIORS \ ENGINEERING

**KKT ARCHITECTS, INC.**  
2200 SOUTH UIC A PLACE, SUITE 200  
TULSA, OKLAHOMA 74114  
[P] 918.744.4270 [F] 918.744.7849  
[WWW.KKTARCHITECTS.COM](http://WWW.KKTARCHITECTS.COM)  
C O F A # 534 6/30/19


SLIITE 800  
AVAILABLE  
9001.36 RSF

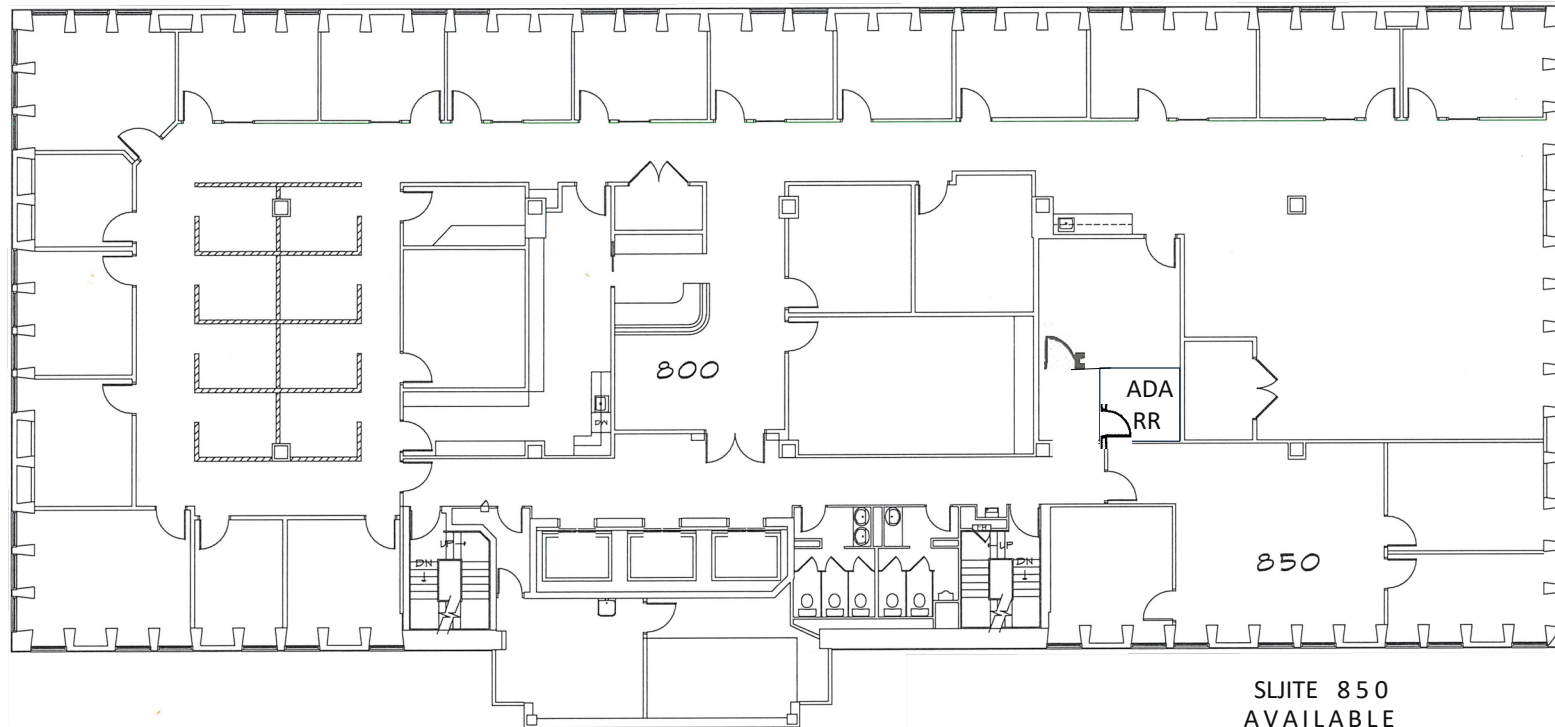

SLIITE 850  
AVAILABLE  
1201.30 RSF

## 8TH FLOOR PLAN

SOUTHLAND  
TOWER  
8TH FLOOR

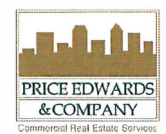

10.25.2010

AS-BUILT  
PLAN

# AS.8