


SUITE 900  
 3270 RSF

SUITE 950  
 VACANT  
 4622 RSF

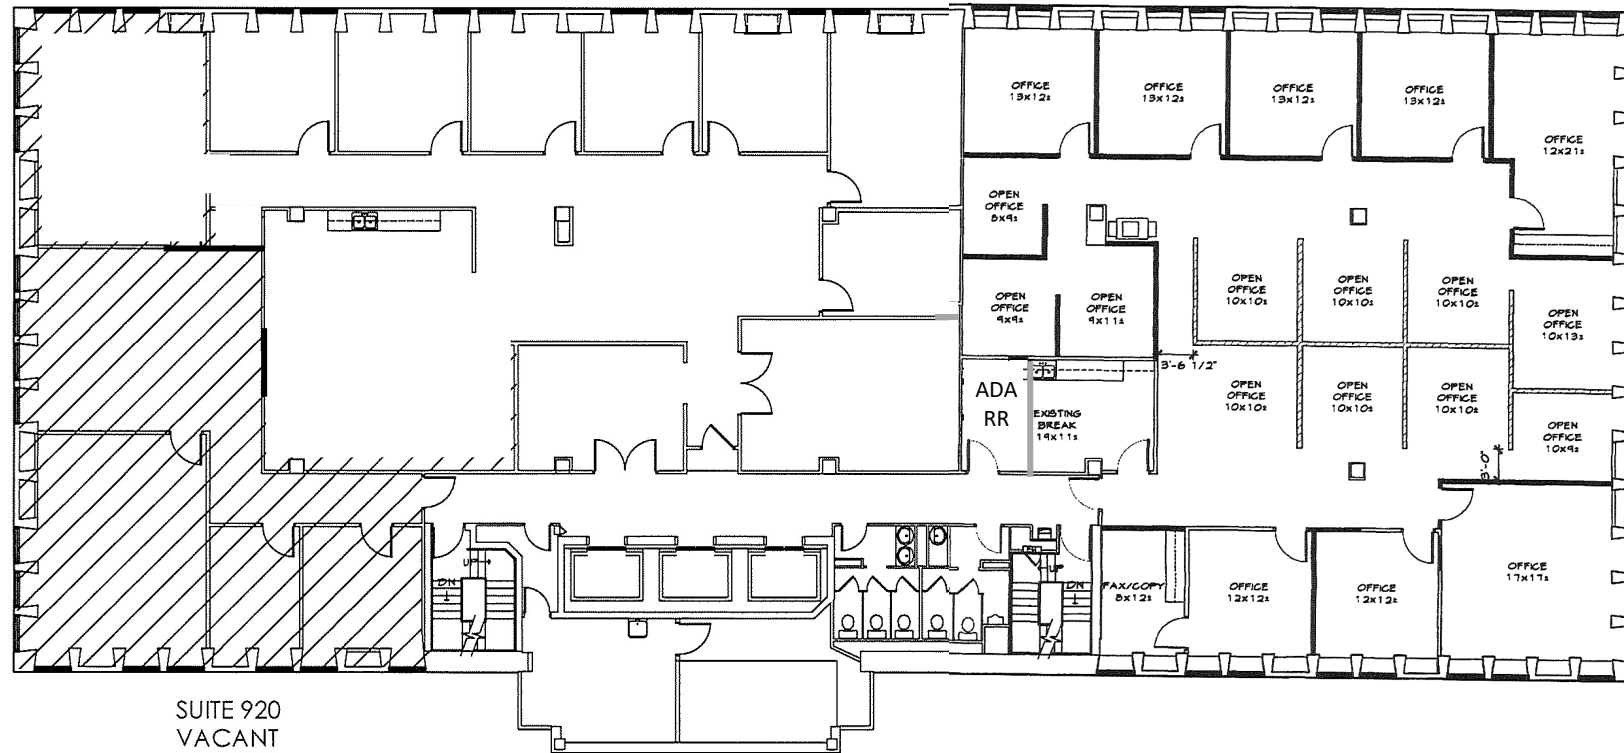

SUITE 920  
 VACANT  
 1483 RSF

**A FLOOR PLAN**   
 SCALE: N.T.S.

**9TH  
 FLOOR**

SOUTHLAND  
 TOWER  
 9TH FLOOR

**PRICE  
 EDWARDS**  
 AND COMPANY

03.05.2021

.....

AS BUILT